



SAMPLING LOCATION ID	COORDINATES		SAMPLING LOCATION ID	AS-BUILT COORDINATES	
	EASTING	NORTHING		EASTING	NORTHING
MEA1	845537.11	814957.03	MEA1	845556.79	814949.77
MEA2	845676.03	815010.36	MEA2	-	-
MEA3	845566.71	814878.35	MEA3	845565.59	814879.11
MEA4	845705.85	814932.03	MEA30	845549.25	814867.29
MEA5	845585.51	814696.16	MEA4	-	-
MEA6	845652.34	814548.43	MEA5	-	-
MEA7	845717.18	814574.76	MEA6	-	-
MEA8	845712.52	814424.79	MEA7	-	-
MEA9	845780.82	814452.69	MEA8	-	-
MEA10	845755.70	814283.56	MEA9	-	-
MEA11	845851.33	814321.29	MEA10	-	-
MEA12	845858.09	814003.69	MEA11	-	-
MEA13	845994.69	814057.86	MEA12	-	-
MEA14	845934.69	813874.27	MEA13	-	-
MEA15	846075.95	813926.00	MEA14	-	-
MEA16	845988.62	813736.97	MEA15	-	-
MEA17	846128.69	813787.96	MEA16	-	-
MEA18	846071.40	813655.40	MEA17	846129.11	813787.85
MEA19	846167.90	813692.71	MEA18	-	-
MEA20	845931.10	814192.99	MEA19	846167.84	813692.71
MEA21	845804.07	814143.83	MEA20	-	-
MEA22	845657.43	814103.16	MEA21	-	-
MEA23	845518.15	814050.42	MEA22	-	-
MEA24	845379.44	813995.44	MEA23	-	-
EA1	846522.86	814578.26	MEA24	-	-
EA2	846384.72	814518.31	EA1	846522.92	814578.28
EA3	846218.21	814372.40	EA2	846384.85	814518.64
EA4	846043.33	814291.14	EA3	-	-
			EA4	-	-

845000 E

846000 E

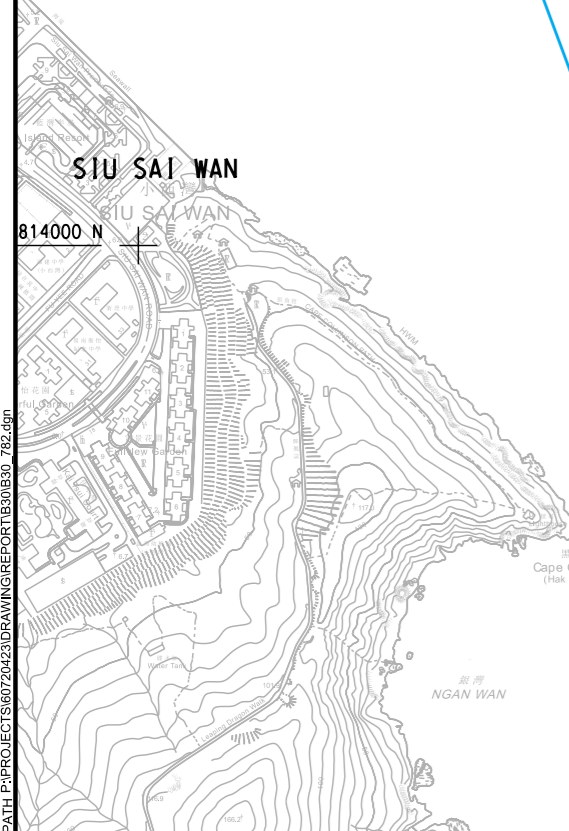

TATHONG CHANNEL TRAFFIC SEPARATION ZONE

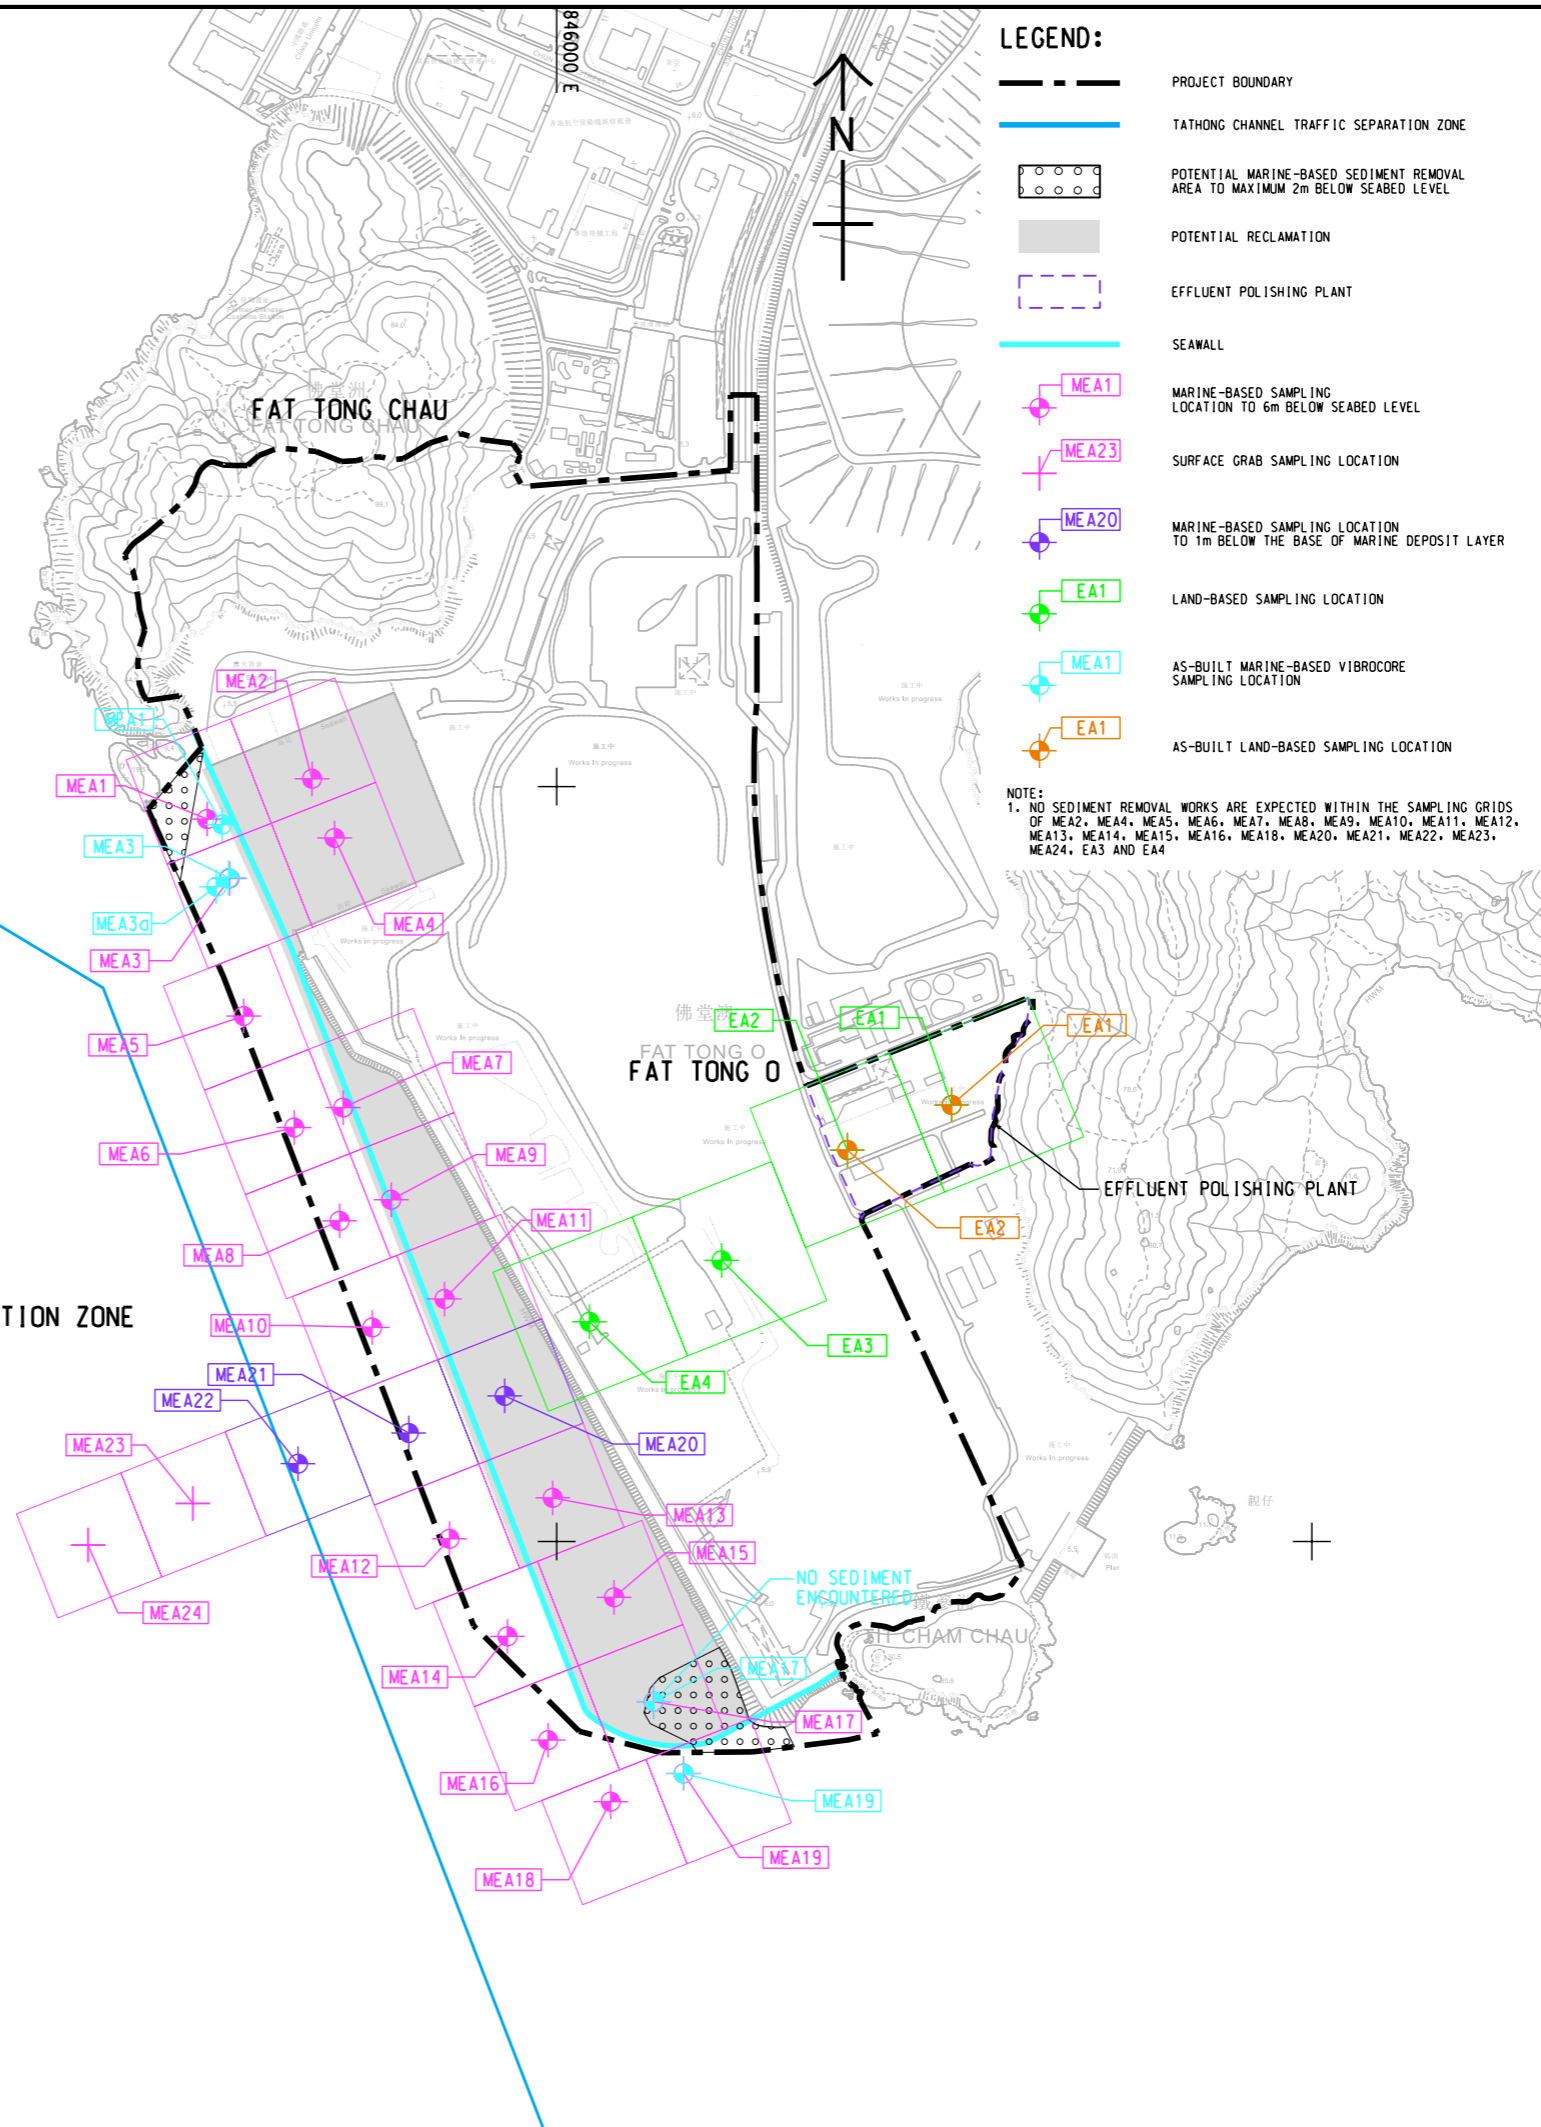

ISSUE/REVISION

I/R	DATE	DESCRIPTION	CHK.

STATUS

SCALE DIMENSION UNIT

A1 1:5000 METRES

KEY PLAN

PROJECT NO. 60720423 CONTRACT NO. CE 40/2023(CE)

SHEET TITLE AS-BUILT SEDIMENT SAMPLING LOCATIONS (TKO 137)

SHEET NUMBER 60720423/B30/FIGURE 7.3