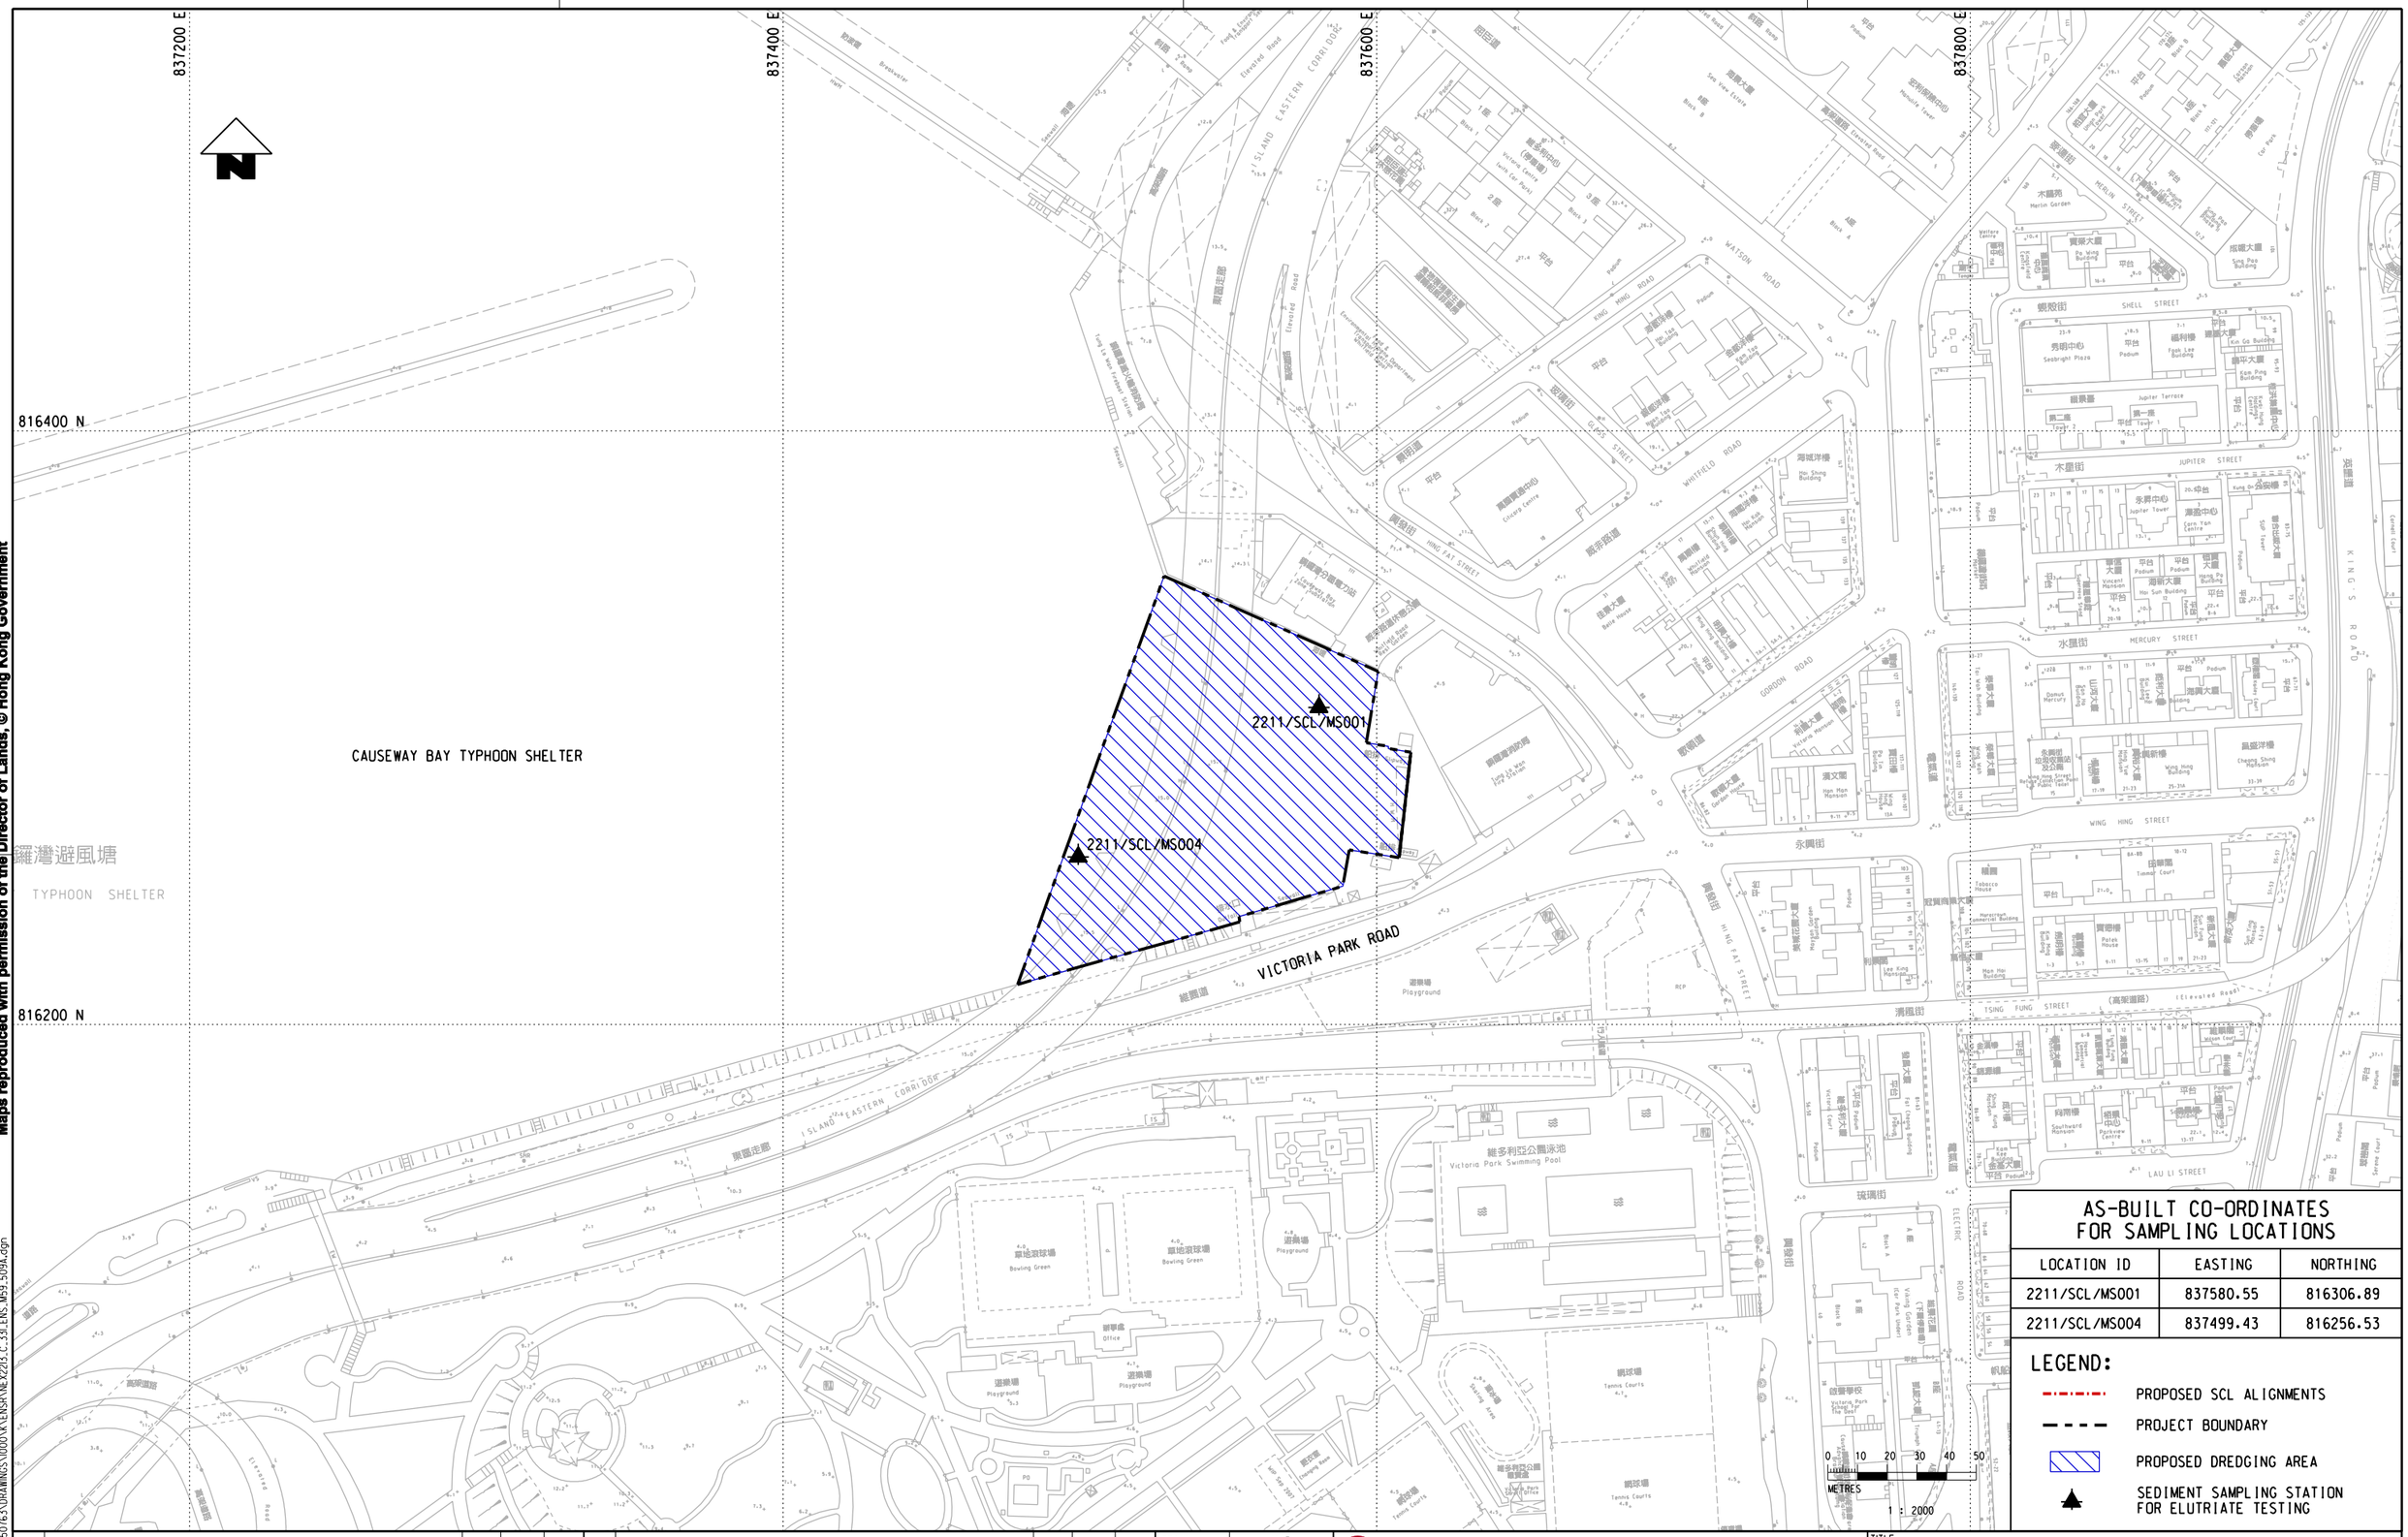

AS-BUILT CO-ORDINATES FOR SAMPLING LOCATIONS

LOCATION ID	EASTING	NORTHING
2211/SCL/MS001	837580.55	816306.89
2211/SCL/MS004	837499.43	816256.53

LEGEND:

- PROPOSED SCL ALIGNMENTS
- PROJECT BOUNDARY
- PROPOSED DREDGING AREA
- SEDIMENT SAMPLING STATION FOR ELUTRIATE TESTING

Maps reproduced with permission of the Director of Lands, © Hong Kong Government

PLOT DRV: R:\ustnset\MTR\PLOTDRIVER\WINDOWS\A3 COLOUR.plt
MODELNAME: Default PRINTED BY: DAIXL 2010-7-21 10:40:38
FILENAME: M:\projects\60050763\DRAWINGS\1000\K\ENSR\NEX2213_C_331_ENS_M59_509A.dgn

REV	DESCRIPTION	BY	DATE	APPROVED	REV	DESCRIPTION	BY	DATE	APPROVED

DRAWN	YJP
DESIGNED	---
CHECKED	LCR
APPROVED	---
DATE	28/JUN/2010

DO NOT SCALE DRAWINGS. ALL DIMENSIONS SHALL BE VERIFIED ON SITE.
© MTR CORPORATION LIMITED 2008 COPYRIGHT IN RESPECT OF THIS DRAWING / DOCUMENT IS OWNED BY THE MTR CORPORATION LIMITED OF HONG KONG. NO REPRODUCTION OF THE DRAWING / DOCUMENT OR ANY PART BY WHATEVER MEANS IS PERMITTED WITHOUT THE PRIOR WRITTEN CONSENT OF THE MTR CORPORATION LIMITED.

MTR

SHATIN TO CENTRAL LINK

ORIGINATOR

AECOM

CADD REF. NEX2213_C_331_ENS_M59_509A.dgn

TITLE

NEX/2213
EIA STUDY FOR SCL PROTECTION WORKS AT CBTS
SEDIMENT SAMPLING STATION FOR ELUTRIATE TESTING
SHEET 2 OF 2

SCALE 1 : 2000 (A3)

FIGURE NO. NEX2213/C/331/ENS/M59/509

REV. A